

SMALL WASTEWATER FACILITY PERMIT

SHERIDAN COUNTY, WYOMING

Fee \$25.00 \$35.00

Subdivision _____ Bk _____ Lot NW 1/4; Sec. 28; T 55 N; R 83 W

Building Site Address 584 US Hwy 14

Owner or Sponsor Dale & Heath

Mail Address P.O. Box 7010

Telephone 267-3548

Installer Mike Fordyce

Mail Address Mountain Home Rd. Shoshone

Telephone 683 2101

GENERAL INFORMATION

1. No. of Living Units 1
2. No. of Bedrooms 3
3. Soil type Sandy
4. Average of percolation test 90 min / inch

5. Ground slope _____ feet/100 ft.

6. Water supply _____

Municipal _____ Community _____

Private Well

7. Size of lot 19.7 Acres

8. Remarks "Depth To Ground Water If Less Than 7 feet?"

Deeper than 7'

SEPTIC TANK

1. Liquid Capacity 1000 gallons
2. Material Cement
3. Length 8'6" Width 5' Depth 6'6"
4. Outlet Depth (from ground level) 2 ft.
5. Distance from: Well 150' Waterlines _____

SECONDARY TREATMENT

1. Field X Bed _____ Other _____
2. Total Sq. Ft. Required 789 850 sq. ft. installed
3. Number of lines _____ Ends Connected NO
4. Trench/Bed (width) 24" (length) 197' Trench + Bed installed
5. Depth of gravel (below pipe) 12" above 2"
6. Washed gravel _____ Size 1/2 to 2 1/2"
7. Depth of cover over pipe 2'
8. Distance from: Well 130' Waterlines _____

PLOT PLAN (show lot lines, well, house, direction or slope, water lines, sewer lines, septic tank with dimensions; Indicate North.)


1-15-93

Mr. & Mrs. Heath:

Keep these papers for future reference.

S. R. Bond SRB
County Inspector

As Built Drawing.
 Dale Heath 58' U.S. Hwy 14

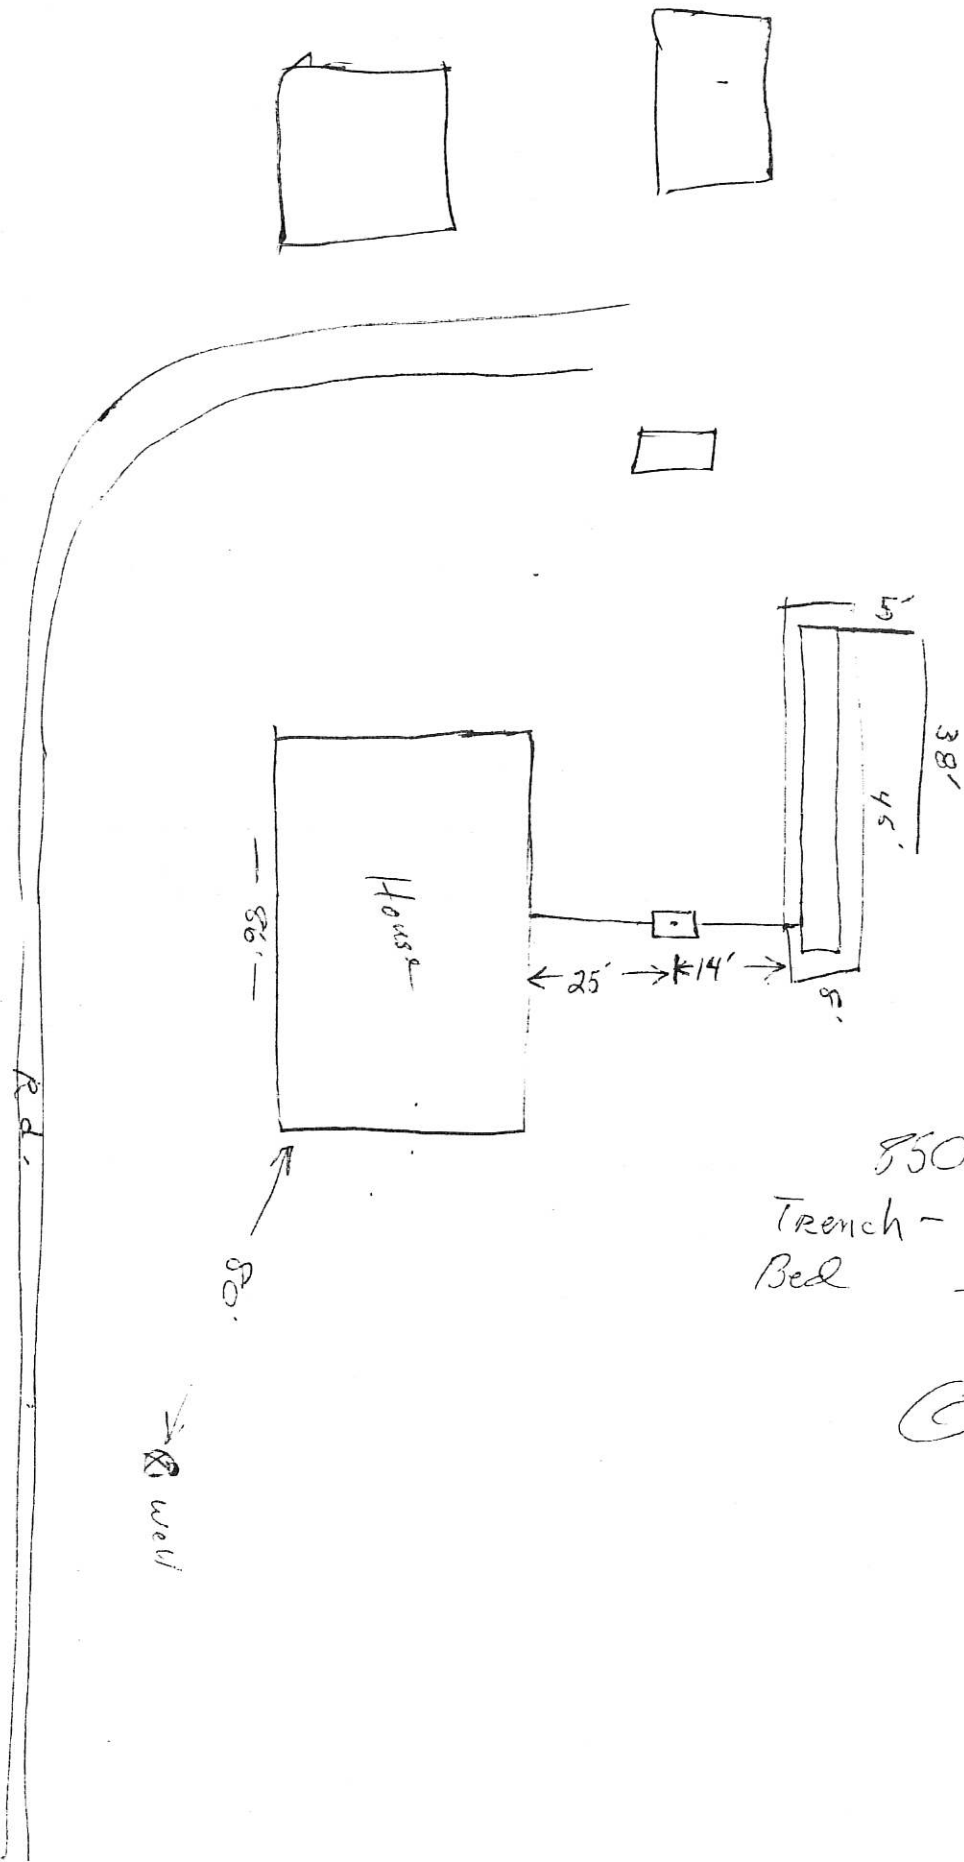

850' sq. ft installed.
 Trench - 172
 Bed 678
 850

OK.

North
 ↑

Apr 27, 2009

